


H500302-2-440-M-GA-0011-01-2 BM

DO NOT SCALE - IF IN DOUBT, ASK

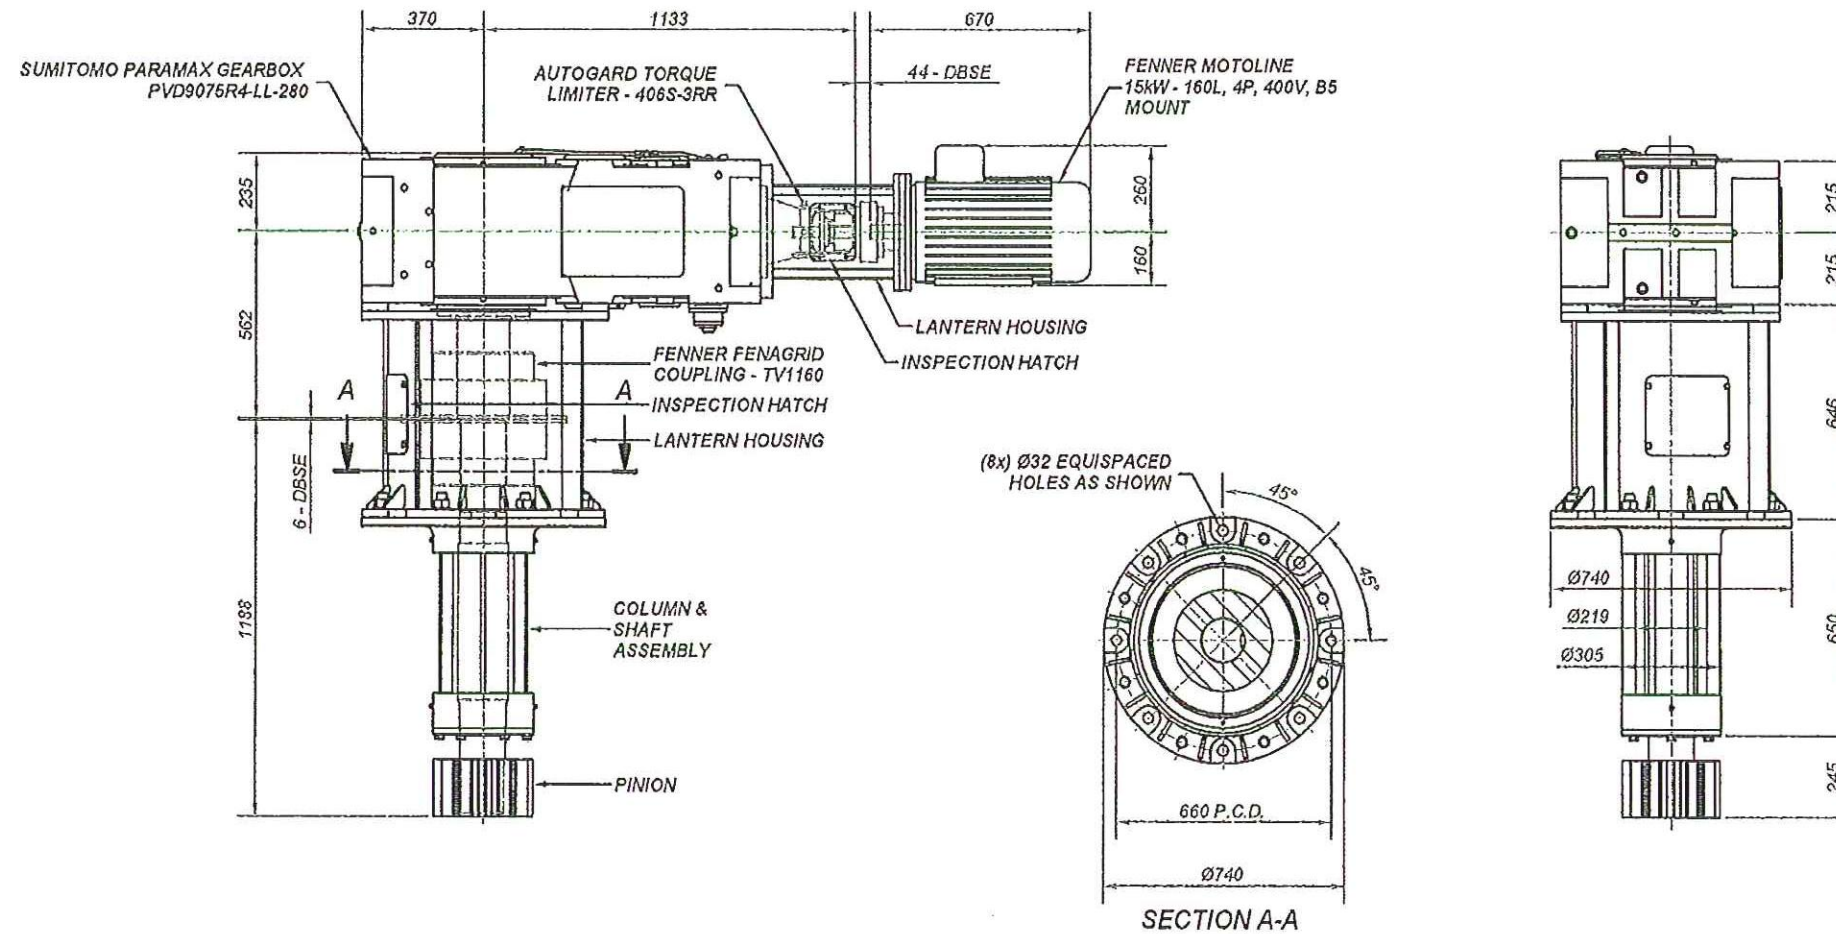

- NOTES:
- SUMITOMO PARAMAX GEARBOX: PVD9075R4-LL-280 VERTICAL MOUNTING, SPLIT HOUSING, RIGHT ANGLE GEARBOX, QUADRUPLE REDUCTION, LEFT HAND, FACING DOWNWARD, FITTED WITH OIL PUMP, ACTUAL RATIO 265.69:1 PAINT SPECIFICATION: SEE NOTE 6
 - FENNER MOTOLINE: 15kW, 160 L, 4P, 400V, B5 MOUNTING, 1460 RPM PAINT SPECIFICATION: SEE NOTE 6
 - HIGH SPEED COUPLING - AUTO GARD TORQUE LIMITER - 406S-3RR
 - LOW SPEED COUPLING - FENAGRID COUPLING: TV1160 - VERTICAL SPLIT
 - (2x) LANTERN HOUSING: FABRICATED LANTERN HOUSING, LANTERN HOUSING PAINT: SEE NOTE 6
 - PAINT SPECIFICATION: HE 9/2/8 VER. 16



EPCM CONSULTANT: TRANSNET PROJECTS				ORIGINATOR: BMG DRIVES			
TITLE	NAME	SIGNATURE	DATE	TITLE	NAME	SIGNATURE	DATE
LEAD DES. ENG.	JK	JK	10/04/10	DRAWN	SVG	SVG	08/06/13
ENG. COORD.				CHECKED	RG	RG	08/06/13
ENG. MANAGER	F.U	F.U	10/04/10	ENG. COORD.			
AREA MANAGER				DISCIP. ENG.			
PROJECT MGR.				ENG. MANAGER			
DIVISION				AREA MANAGER			
DIV.	TITLE	NAME	SIGNATURE	DATE	PR.ENG. / PR.TECH.	NAME	DATE
				YY MM DD			YY MM DD
					REG. NUMBER		
					SCALE: 1:14		

DRAWING NO.	REFERENCE	REVISIONS / ISSUE AUTHORIZATION
2	AS BUILT	SVG RG FP 01/04/10
1	CHANGED G/BOX 9060 TO 9075	SVG RG GE 01/12/09
0	ISSUED FOR CONSTRUCTION	SVG RG FP 05/02/09

NO.	DESCRIPTION	BY	CHK'D	APP'D	DATE

PROJECT NUMBER	DV	FBS	DIS	TYPE	DRG. NO.	SHT.	REV.	ID
H500302-2-440-M-GA-0011-01-2 BM								

PE MANGANESE TERMINAL REFURBISHMENT
TPT - PORT EXPORT SYSTEM
RECLAIMER
SLEW DRIVE
PDMA-7103

SIZE: A2 DATE: 2010/12/15