H500302 2 442 M GA 0003 01

DRAWING NUMBER

DO NOT SCALE - IF IN DOUBT, ASK

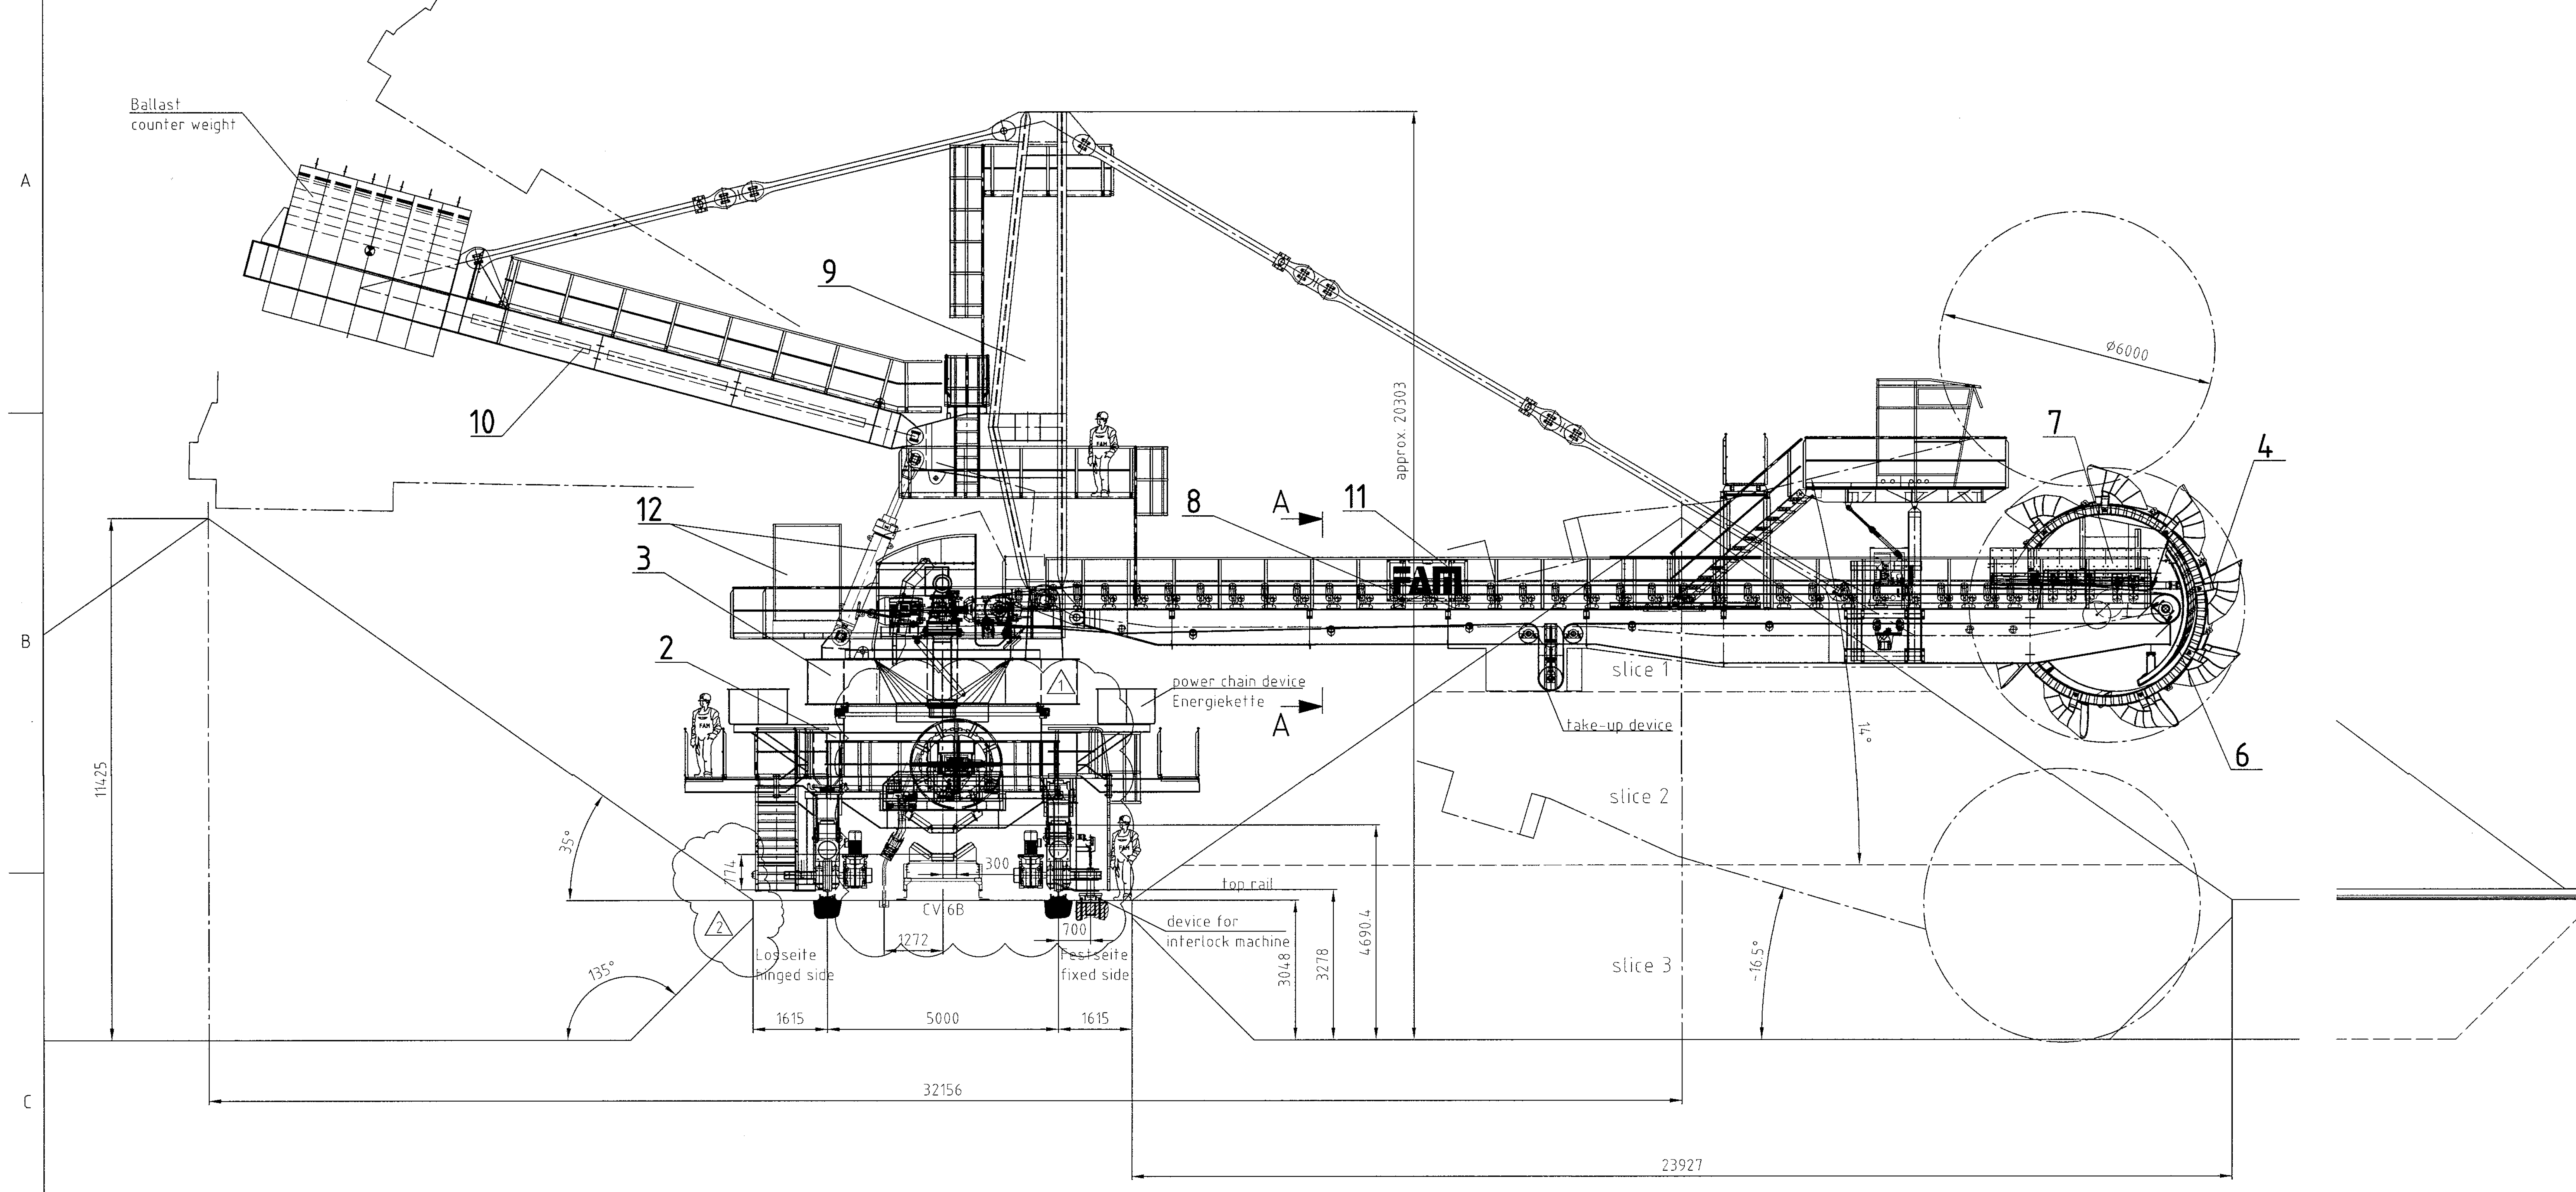

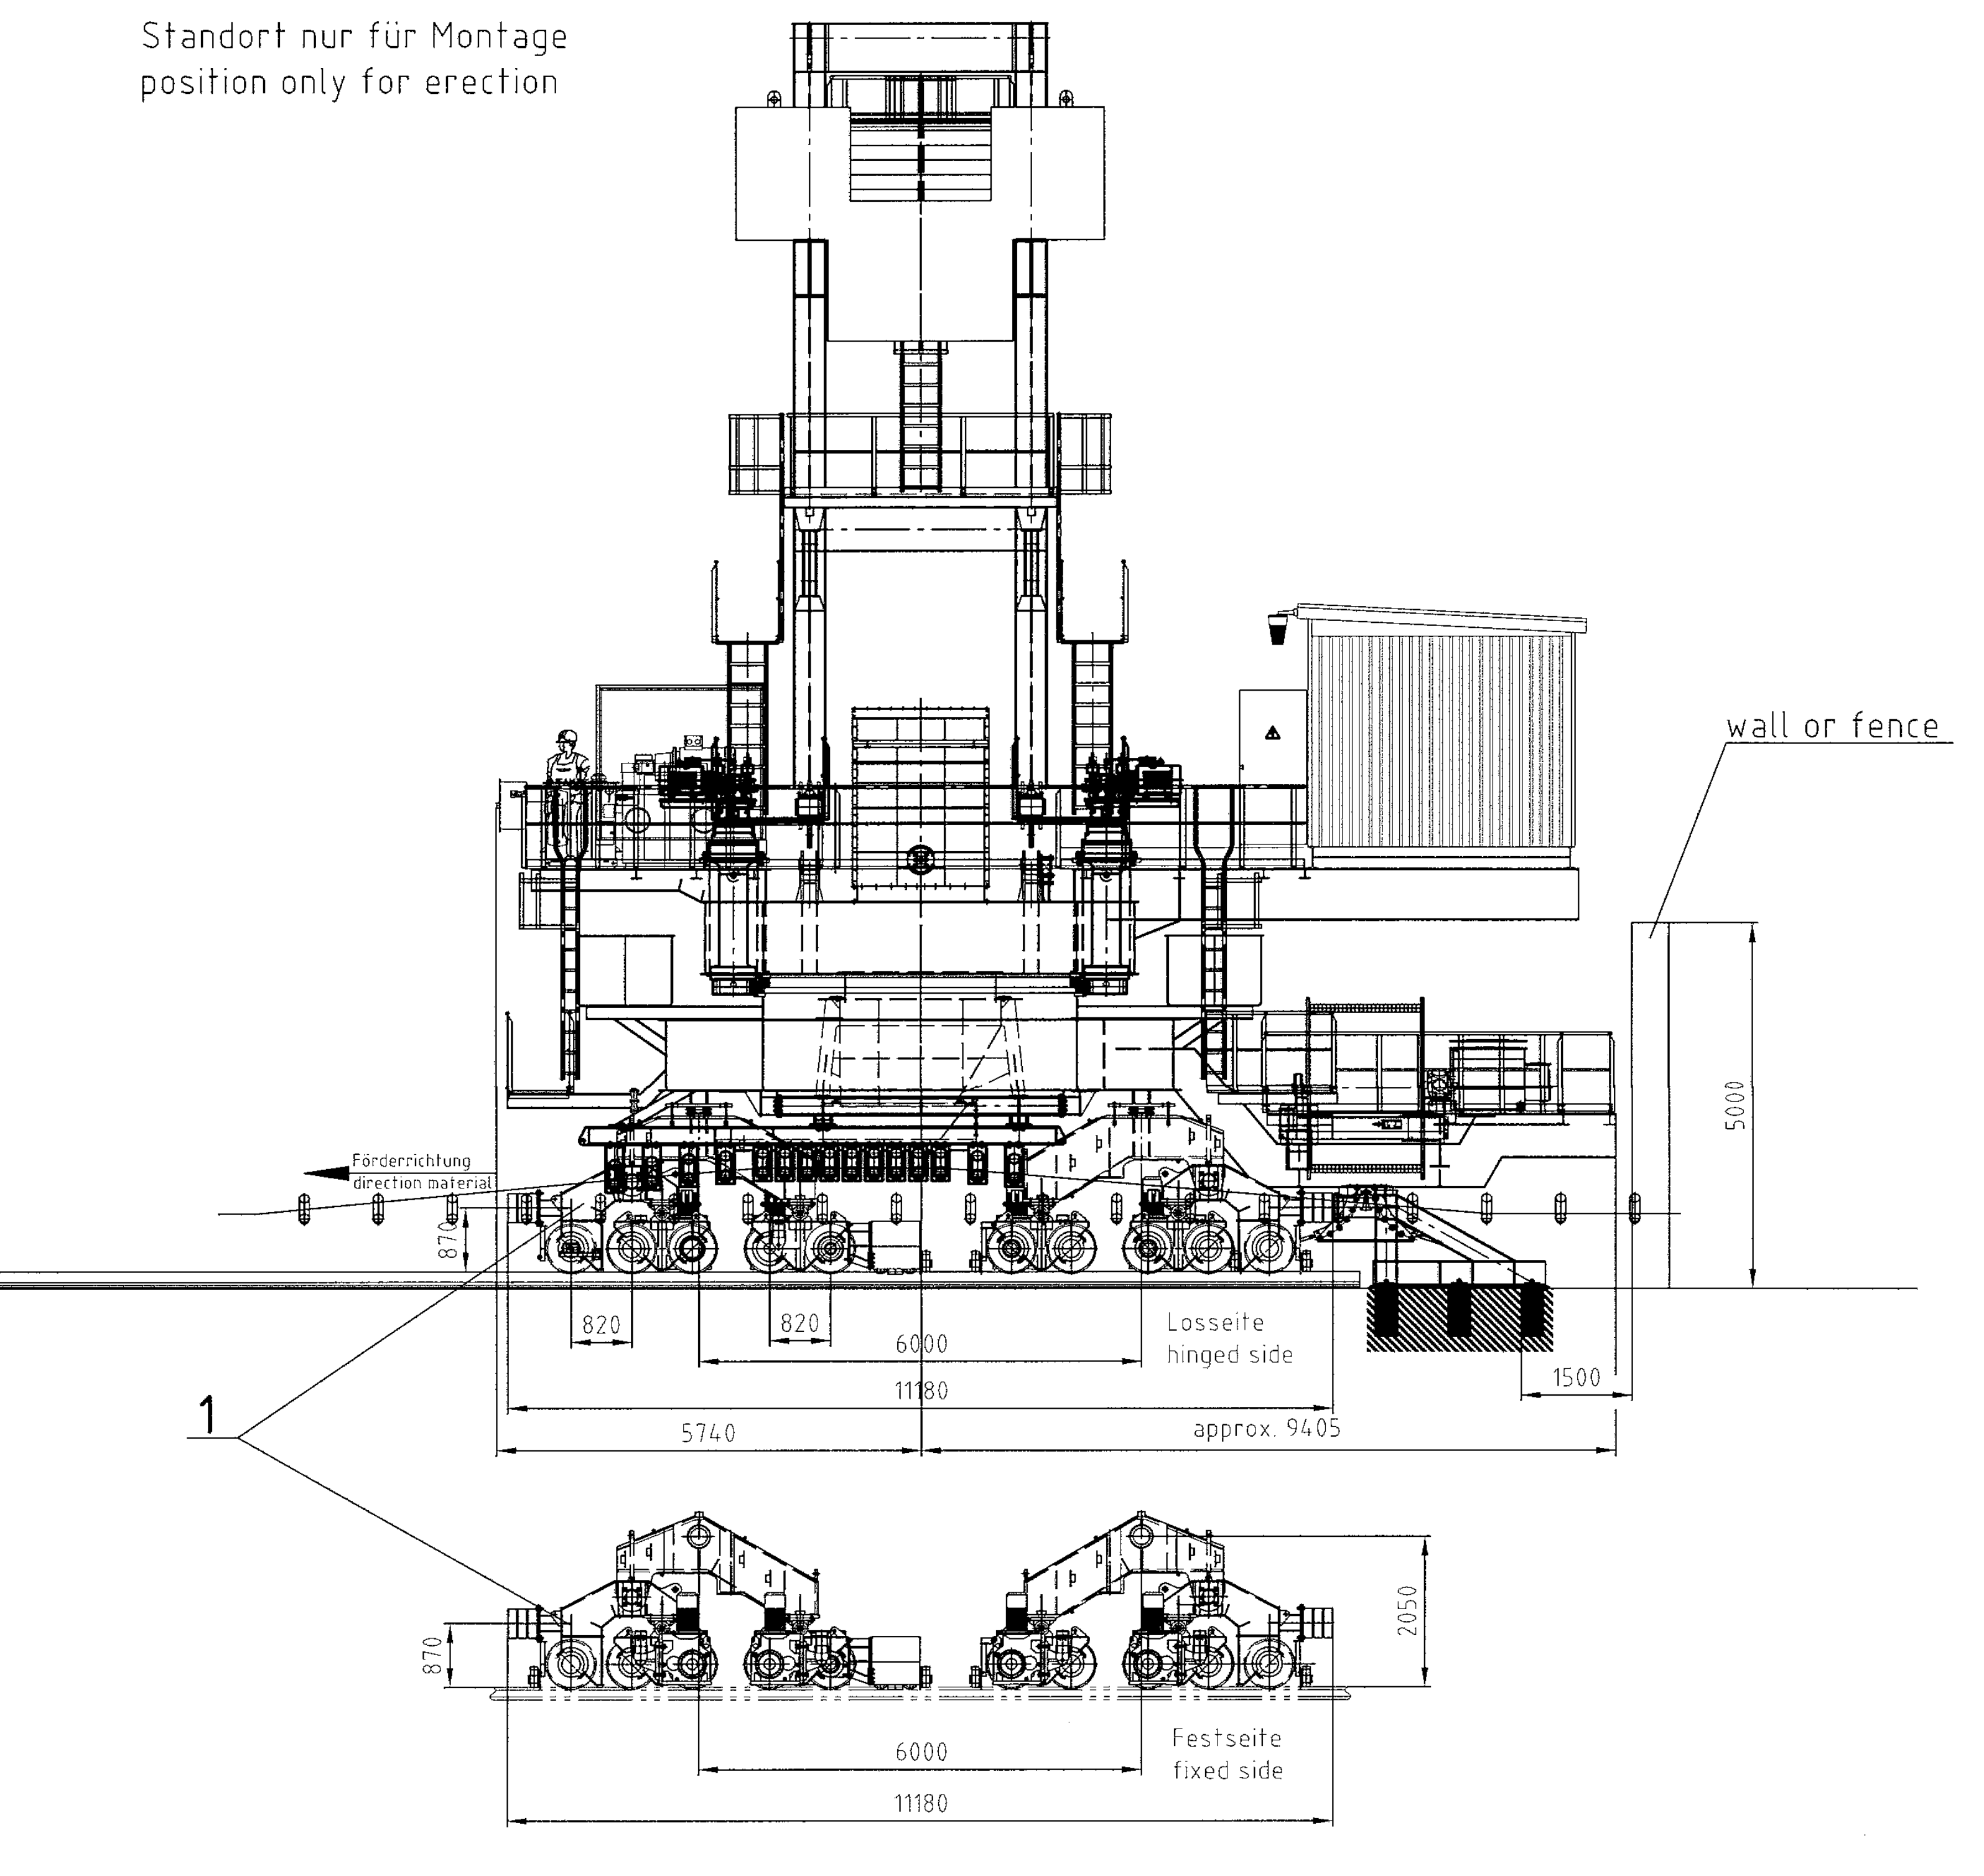

boom in 0°-position

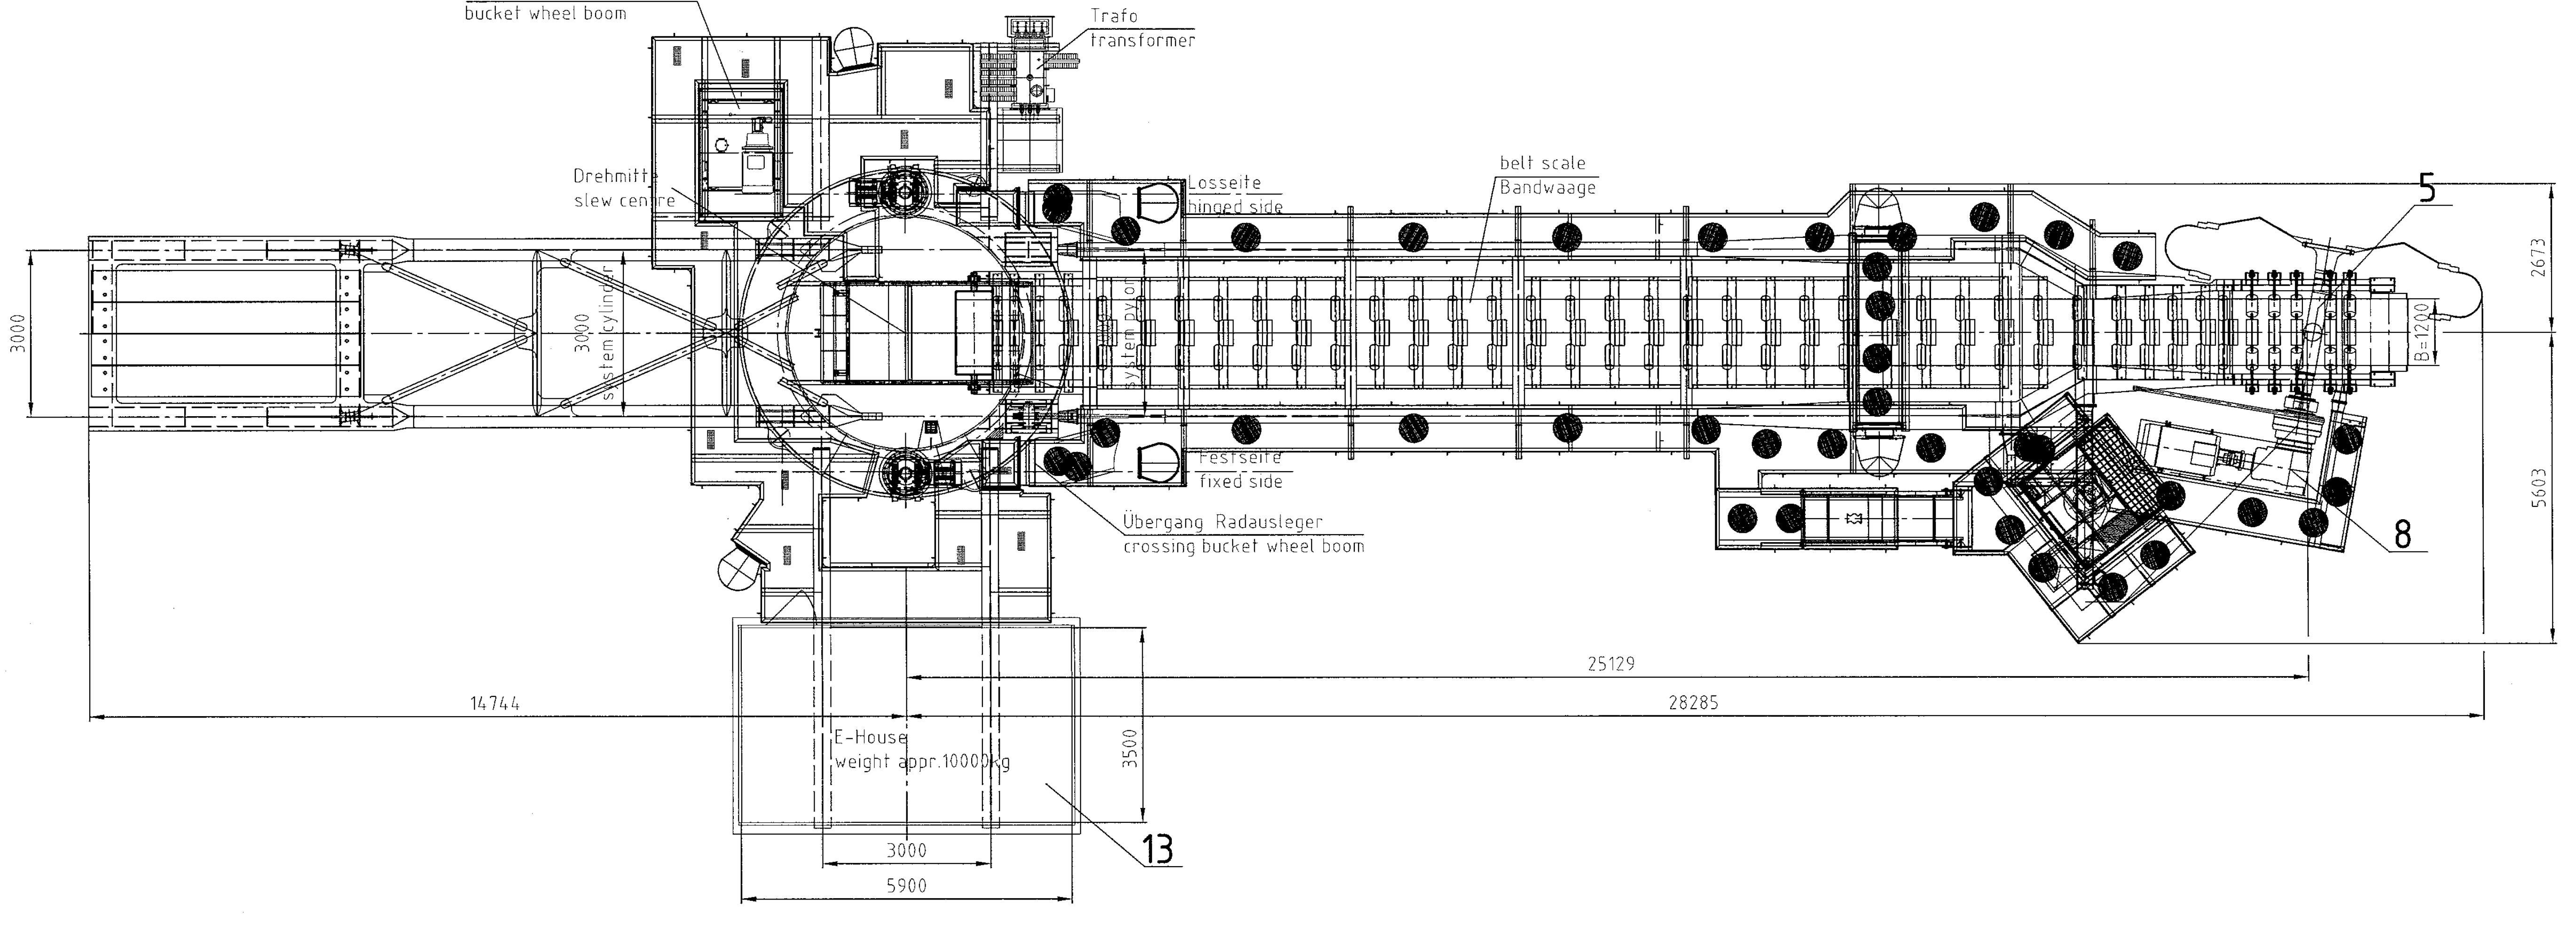

undergarriage with long travel / Unterbau mit Fahrwerk

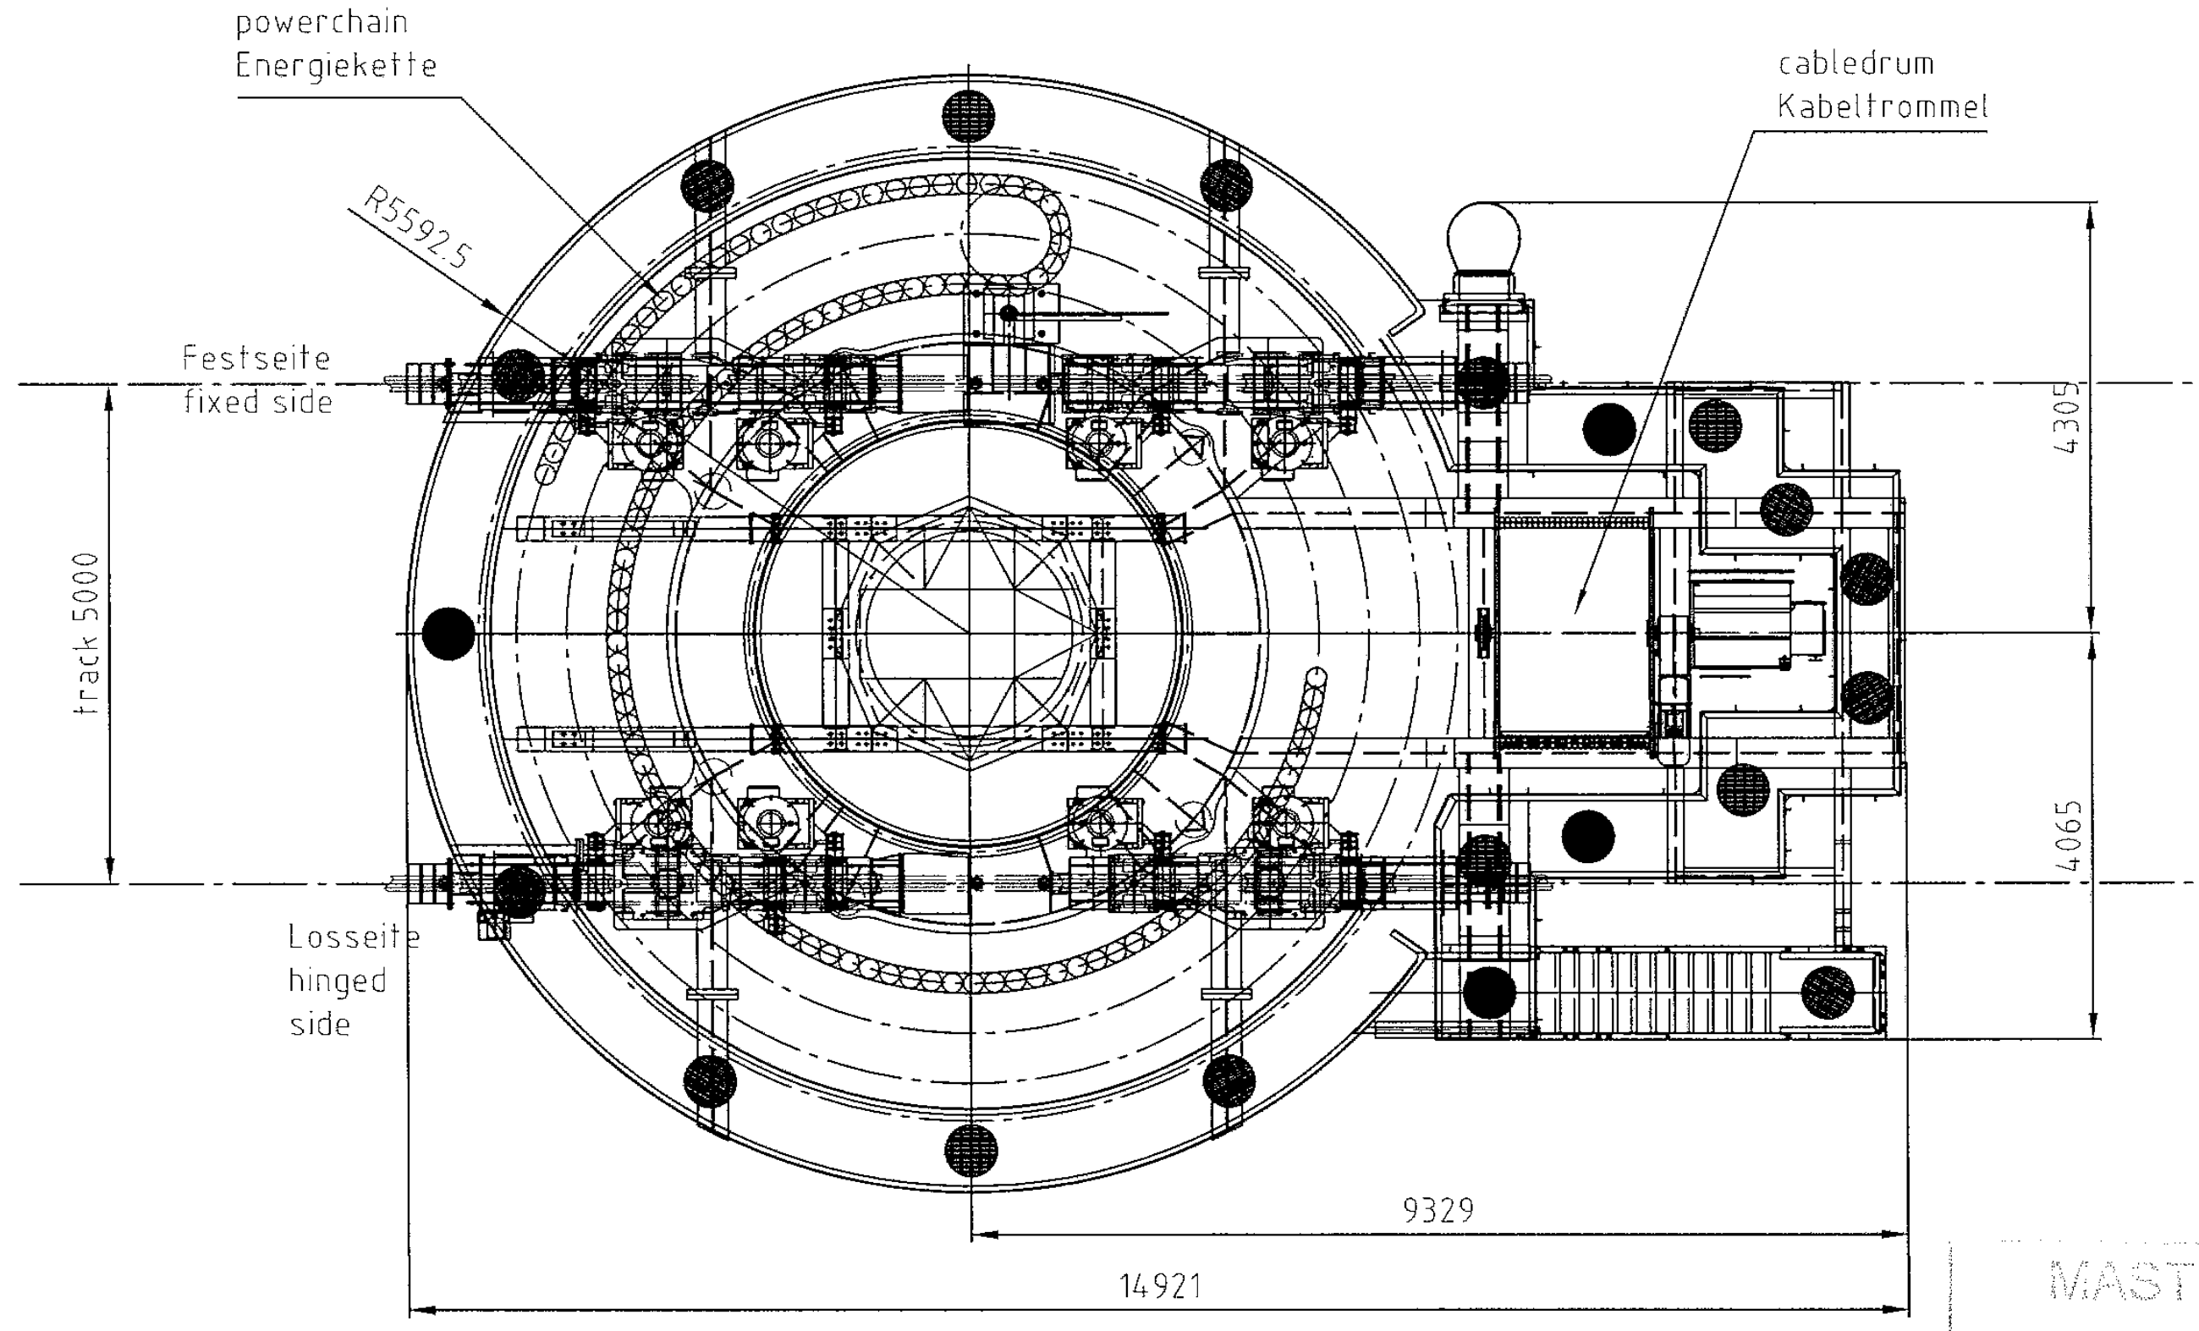

MASTER
2010 -04- 30
TRANSNET

park position boom for maintenance

scale 1:50

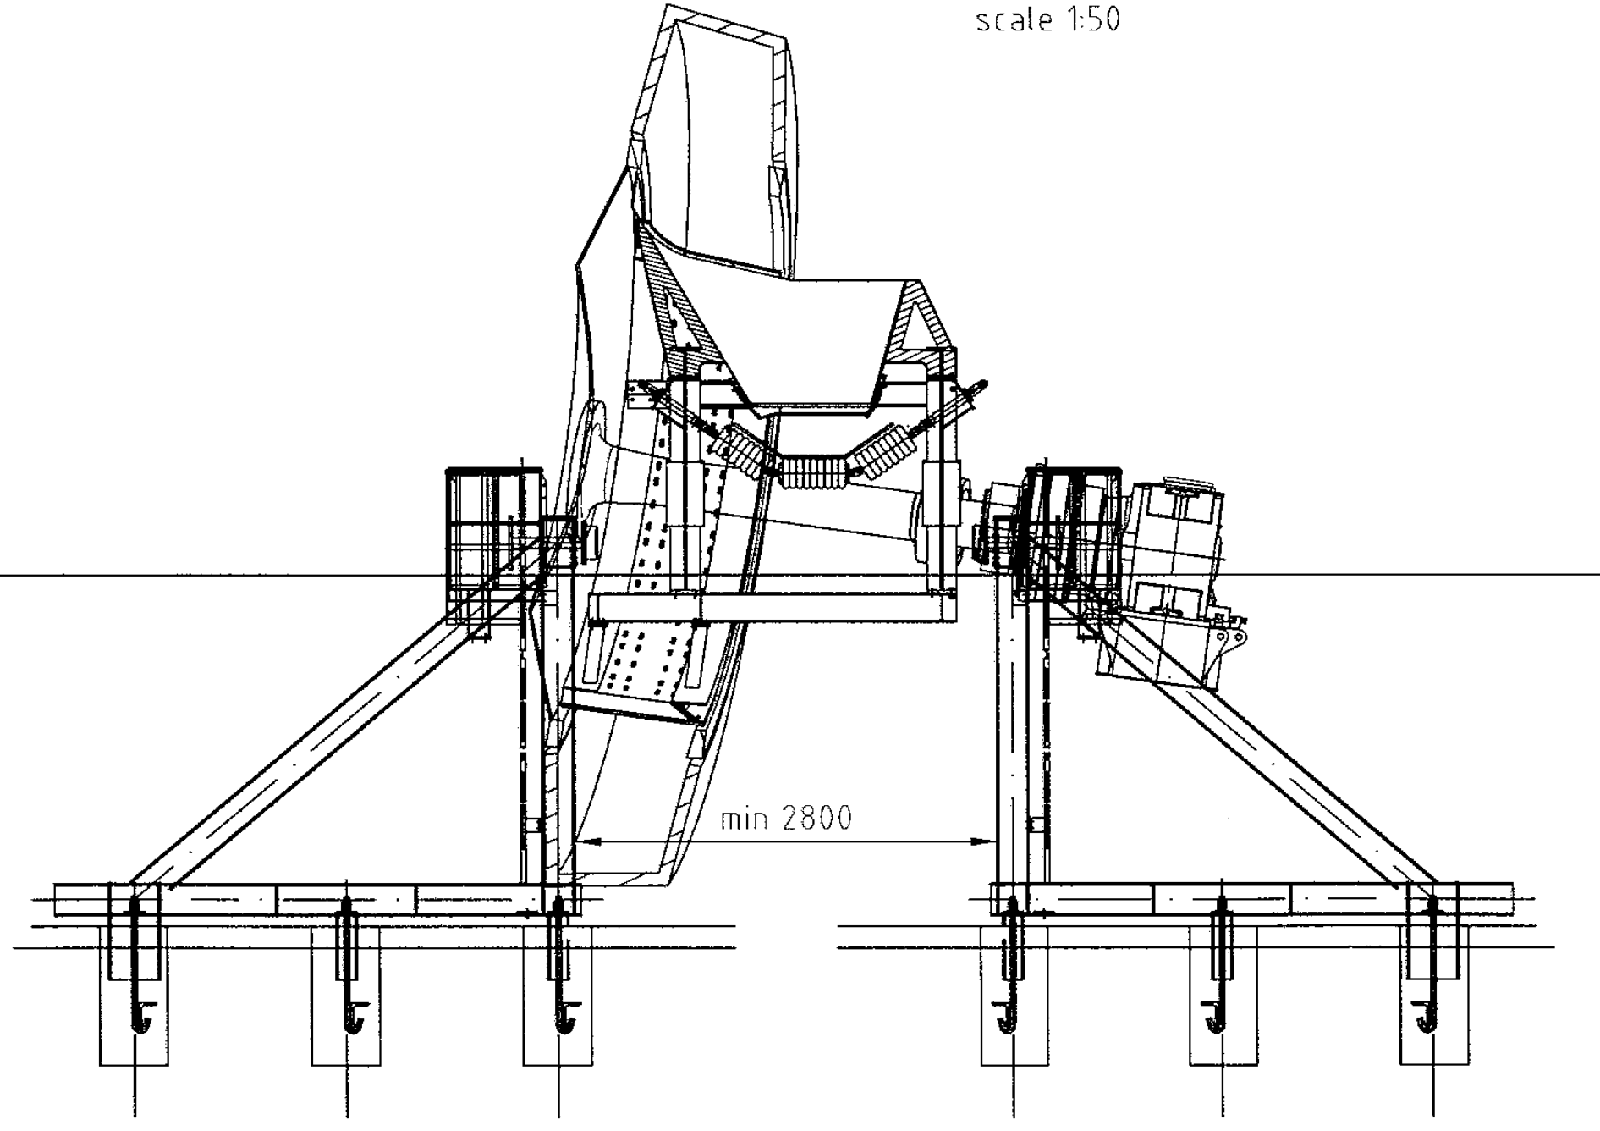

Section A-A

scale 1:20

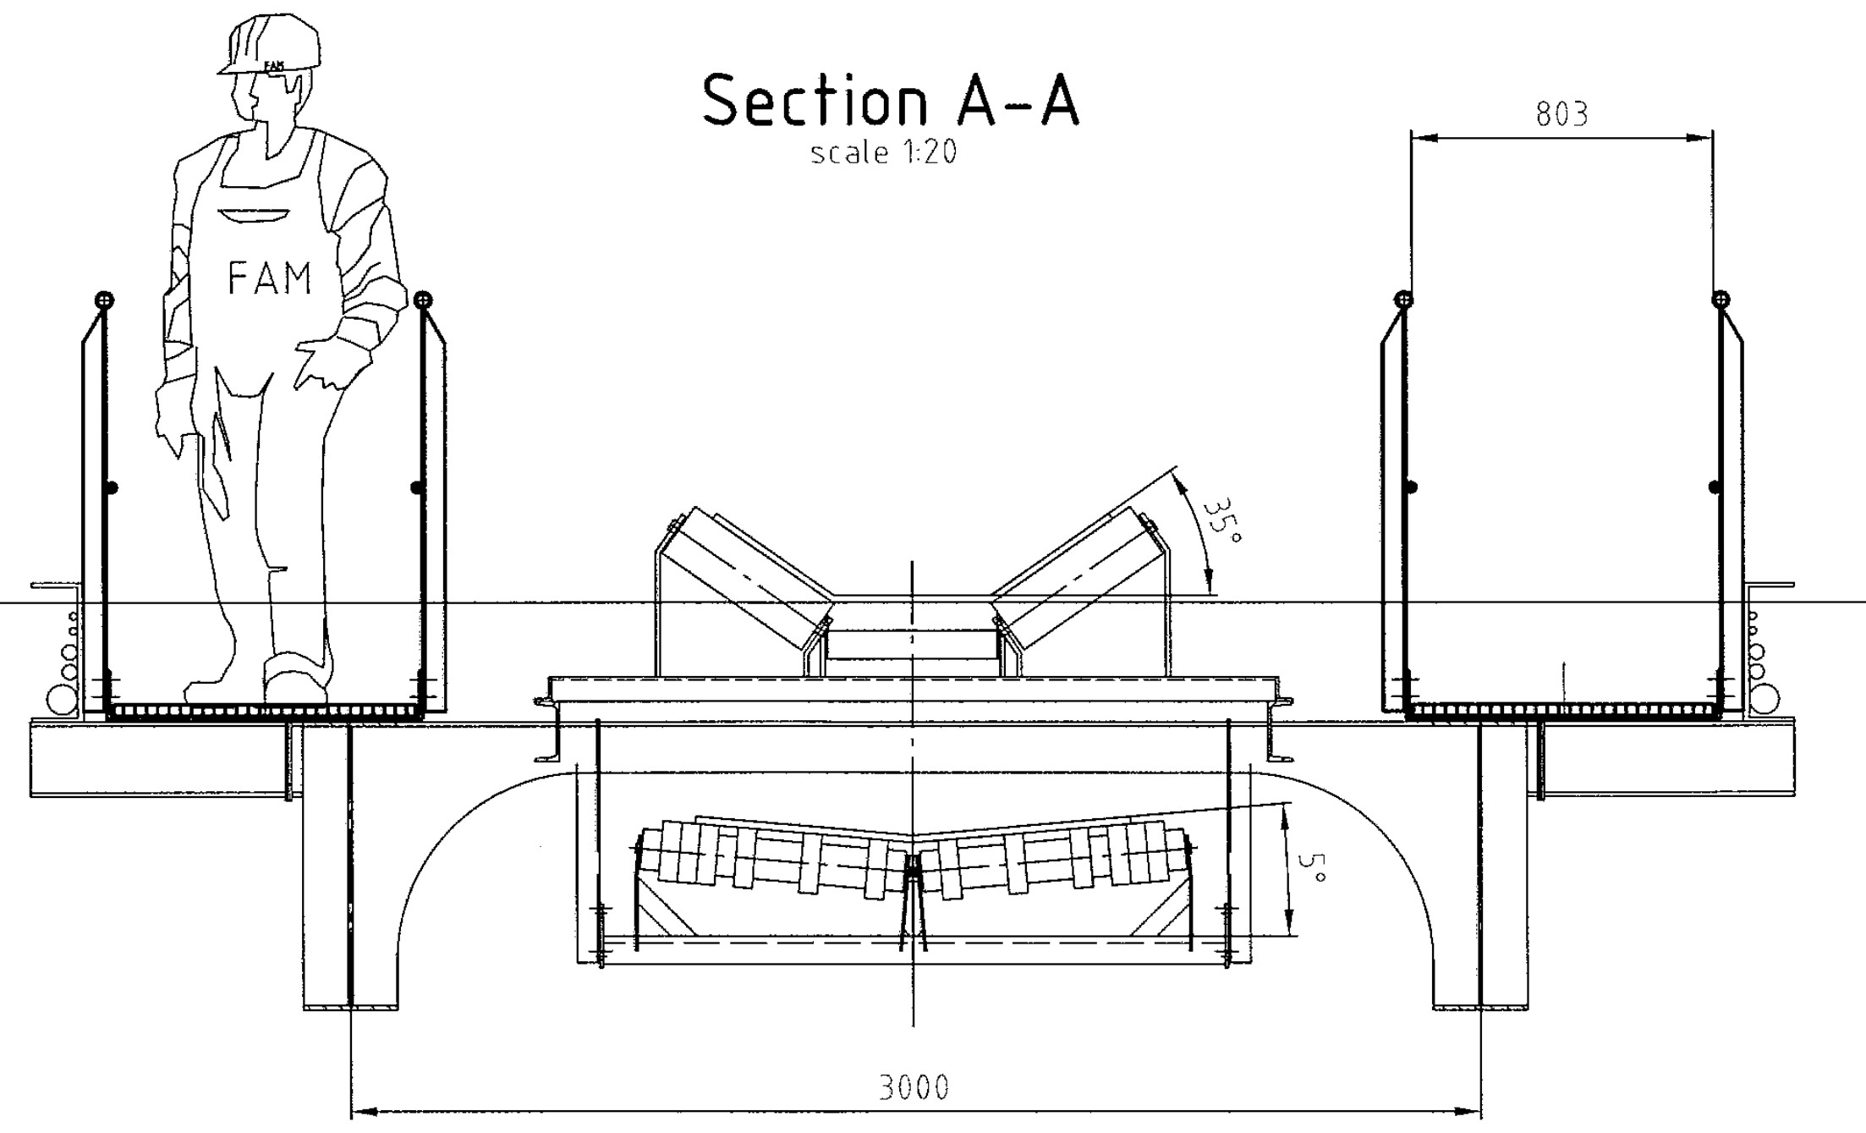

CONTRACTOR REVIEW LABEL

Discipline	Name	Signature	Date	Mandatory	Optional	Accepted	Accepted with Comments	Revise & Resubmit
	J Claassen		5/5/10	Y		✓		
	F Venter		10/5/5	Y		✓		

REVIEW CODE – ASSIGNED BY PROJECT MANAGER

C1	Accepted, Submit 'IFC/IFU'	C4	Review Not Required
C2	Accepted with Comments, Revise & Submit 'IFC/IFU'	C5	Accepted*/'IFC/IFU' Accepted*
C3	Not Accepted, Revise & Resubmit for Review	C6 ✓	'As-Built*/Final*' Accepted

Date 5/5/10 PROJECT MANAGER Signature:

This review is only for general conformance with the design concept of the Project and general compliance with the information given in the contract documents.

NOTE! THIS DRG. TO BE READ IN
CONJUNCTION WITH SHT.1 to 2

The copyright of this drawing remains with the Magdeburger Foerderanlagen und Baumaschinen GmbH(FAM). All rights reserved. No part of this drawing may be reproduced, disclosed to third parties, stored in information retrieval systems, or transmitted, in any form or by any means- electronic, mechanical, photocopying, recording or otherwise- without prior written permission of FAM. All rights reserved for all subjects, components, details and/or procedures/techniques shown and represented in this drawing, particularly also for granting of patents or registration of utility models as well as for any other proprietary rights. Infringements of such rights will result in assertions of injunctive

Part no.	Qty	Material-no.	Drawing no.	Name of Part	size	Standard	Material	unit weight	total weight	remarks
13	1	--------	57.011.08.04 - basic	E-Ausrüstungen (Endschalter, Trafo, E-Haus, Kabine) E-Equipments (limit switches, trafo, electr. house, cabine)		ELB		22000	22000	delivery ELB
12	1	--------	57.011.08.02 - basic	Verlagerung Hydraulik komplett support hydraulic complete		ELB		7000	7000	delivery ELB
11	1	--------	57.011.08.01 - basic	Verlagerung Schilder support signs		ELB		145	145	delivery ELB
10	1	--------	57.011.07- basic	Gegenausleger komplett mit Ballast counterweight boom complete with counterweight		ELB		135000	135000	delivery ELB
9	1	--------	57.011.06 - basic	Mast komplett pylon complete		ELB		23000	23000	delivery ELB
8	1	--------	57.011.05 - basic	Radausleger mit Bandstraße inkl. Schaufelrad-Antrieb bucket wheel boom with conveyor incl. bucket wheel-drive		ELB		46000	46000	delivery ELB
7	1	09148492	57.011.04.04	Aufgabeschurre Schufelrad komplett transfer chute bucket wheel complete		FAM / ELB		2345	2345	detail eng. FAM manufacture and delivery ELB
6	1	09148484	57.011.04.03	Leitschurre Schaufelrad komplett ring chute bucket wheel complete		FAM / ELB		1300	1300	detail eng. FAM manufacture and delivery ELB
5	1	09148446	57.011.04.02	Lagerung Schaufelradwelle support bucket wheel		FAM		2426	2426	detail eng. manufacture and delivery FAM
4	1	09106795	57.011.04.01	Schaufelrad mit Schaufeln 0,4m³ bucket wheel with shovels		FAM		7701	7701	detail eng. manufacture and delivery FAM
3	1	--------	57.011.03 - basic	Oberbau komplett slew deck complete		ELB		44000	44000	delivery ELB
2	1	--------	57.011.02 - basic	Unterbau komplett substructure complete		ELB		35200	35200	delivery ELB
1	1	09143611	57.011.01	Schienenfahrwerk long travel gear		FAM		36350	36350	detail eng manufacture and delivery FAM

For general notes
see Drg.No 1.00887

total mass:
363~ t

ELB
ENGINEERING SERVICES

FAM
Magdeburger Foerderanlagen
und Baumaschinen GmbH

ELB–FAM DRG.No
57.011

NO.	DESCRIPTION	BY	CHK'D	APP'D	DATE
4	AS BUILT	P.M.	O.N.		26.04.2010
3	AS BUILT	P.M.	O.N.		20.09.2009
2	BELT WAS 740mm TO TOP OF RAIL	C VINCENT	O.N.		23.07.2009
1	CABLE REEL AND CONV MODELS UPDATED	C VINCENT	O.N.		16.07.2009
0	ISSUED FOR CONSTRUCTION	G.Jurkovic	O.N.		02.02.2009

REVISIONS / ISSUE AUTHORIZATION

This Document including all design and information therein is Confidential Intellectual Property of Transnet and/or HMG JV. Copyright and all other rights are reserved by Transnet and/or HMG JV. This Document may only be used for its intended purpose.

EPCM CONSULTANT:

TITLE	NAME	SIGNATURE	DATE
LEAD DES. ENG.	S.Claassen		5 5 10
ENG. COORD.			
ENG. MANAGER	F.Venter		10 05 05
AREA MANAGER			
PROJECT MGR.			

DIVISION

DIV.	TITLE	NAME	SIGNATURE	DATE

ORIGINATOR:

TITLE	NAME	SIGNATURE	DATE
DRAWN	Matthias	T.M	23 05 08
CHECKED	KRIESCH	A.K	23 05 08
ENG. COORD	Ngubane	ON	10 06 09
DISCIP. ENG.	Kiesch	AK	10 06 09
ENG. MANAGER	Lawrence	GL	10 06 09
AREA MANAGER	Wilson	BW	10 06 09

PR.ENG. / PR.TECH.

NAME Pihs/Mattias NGUBANE DATE
SIGNATURE TM/PP 10 06 09
REG. NUMBER FAM-Germany 20070153
SCALE : 1:75 OR AS NOTED A0

TRANSNET

ELB / TRANSNET

PE-MANGANESE TERMINAL RECLAIMER

FAM–PROJECT 110979
RECLAIMER–RE 3000.25
G.A.

PROJECT NUMBER	DV	FBS	DIS.	TYPE	DRG. NO.	SHT.	REV.	ID
H500302	2	442	M	GA	0003	01	-4	EL

SIZE:A0 DATE: 2006/12/05

$FILE$ $DATE$ $USERNAME$ $TIME$

DRAWING NO.	REFERENCE

REFERENCE DRAWINGS