

IF IN DOUBT ASK ! – UKUBA UYATHANDABUZE BUZA!

Contract	Drawing	Rev
1233	15	01

ALL NOTES AS PER DRAWING NO. 1233–12 PERTAIN AND ARE APPLICABLE TO THIS DRAWING

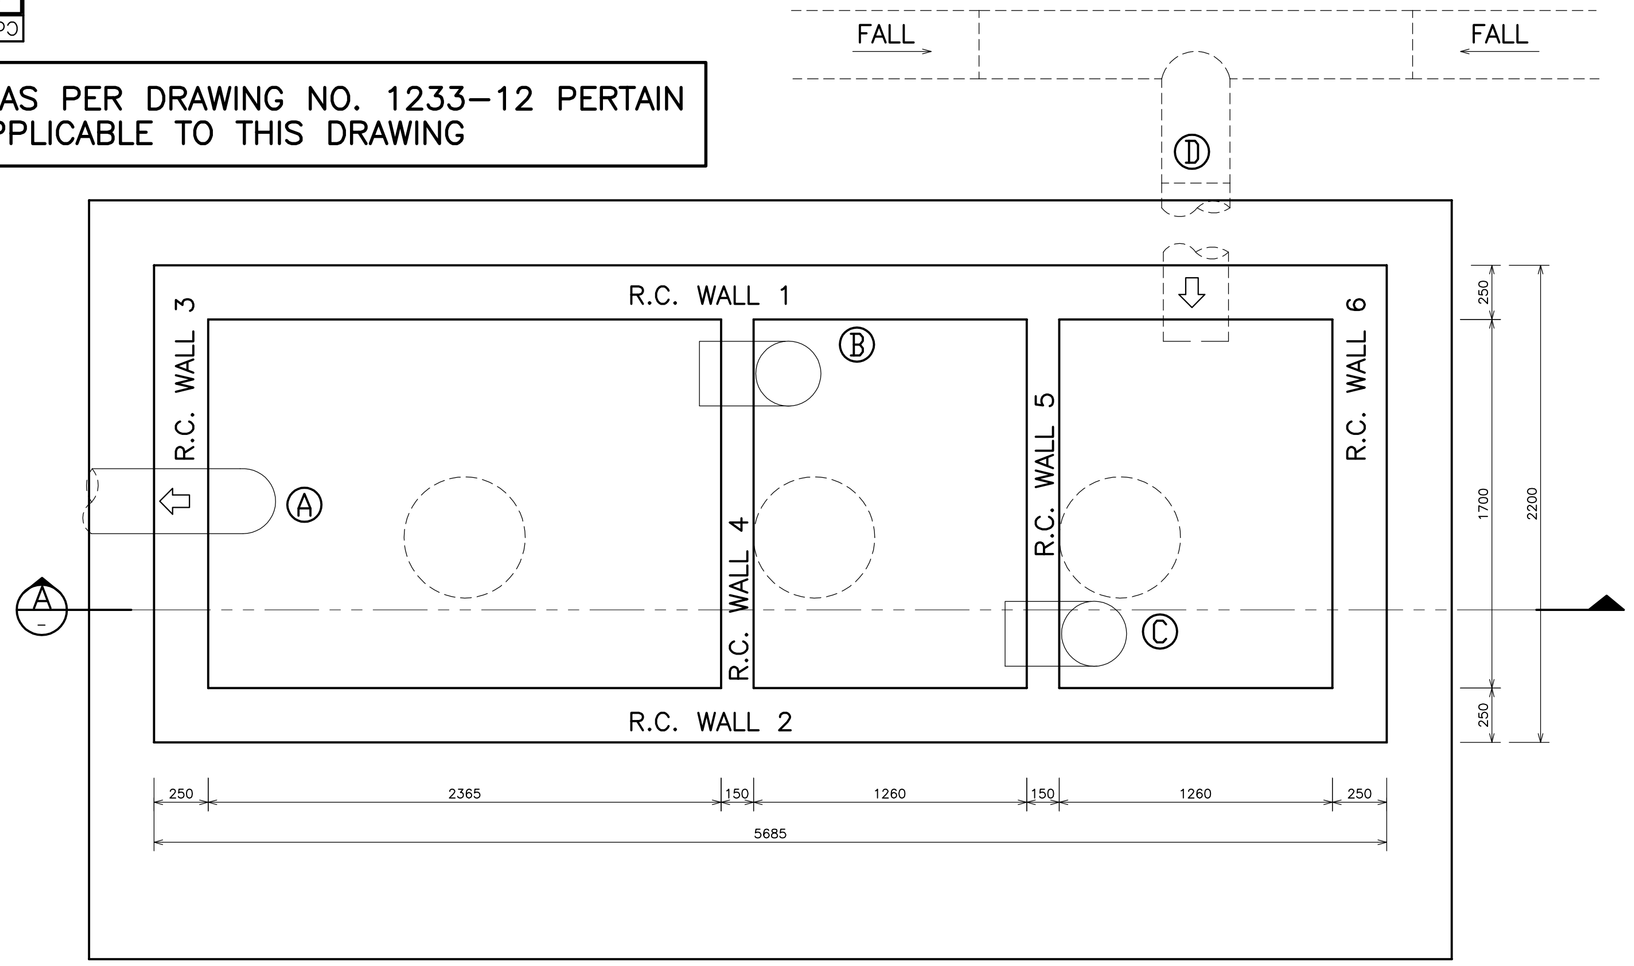


PLAN: FOUNDATION LAYOUT
SCALE 1:20

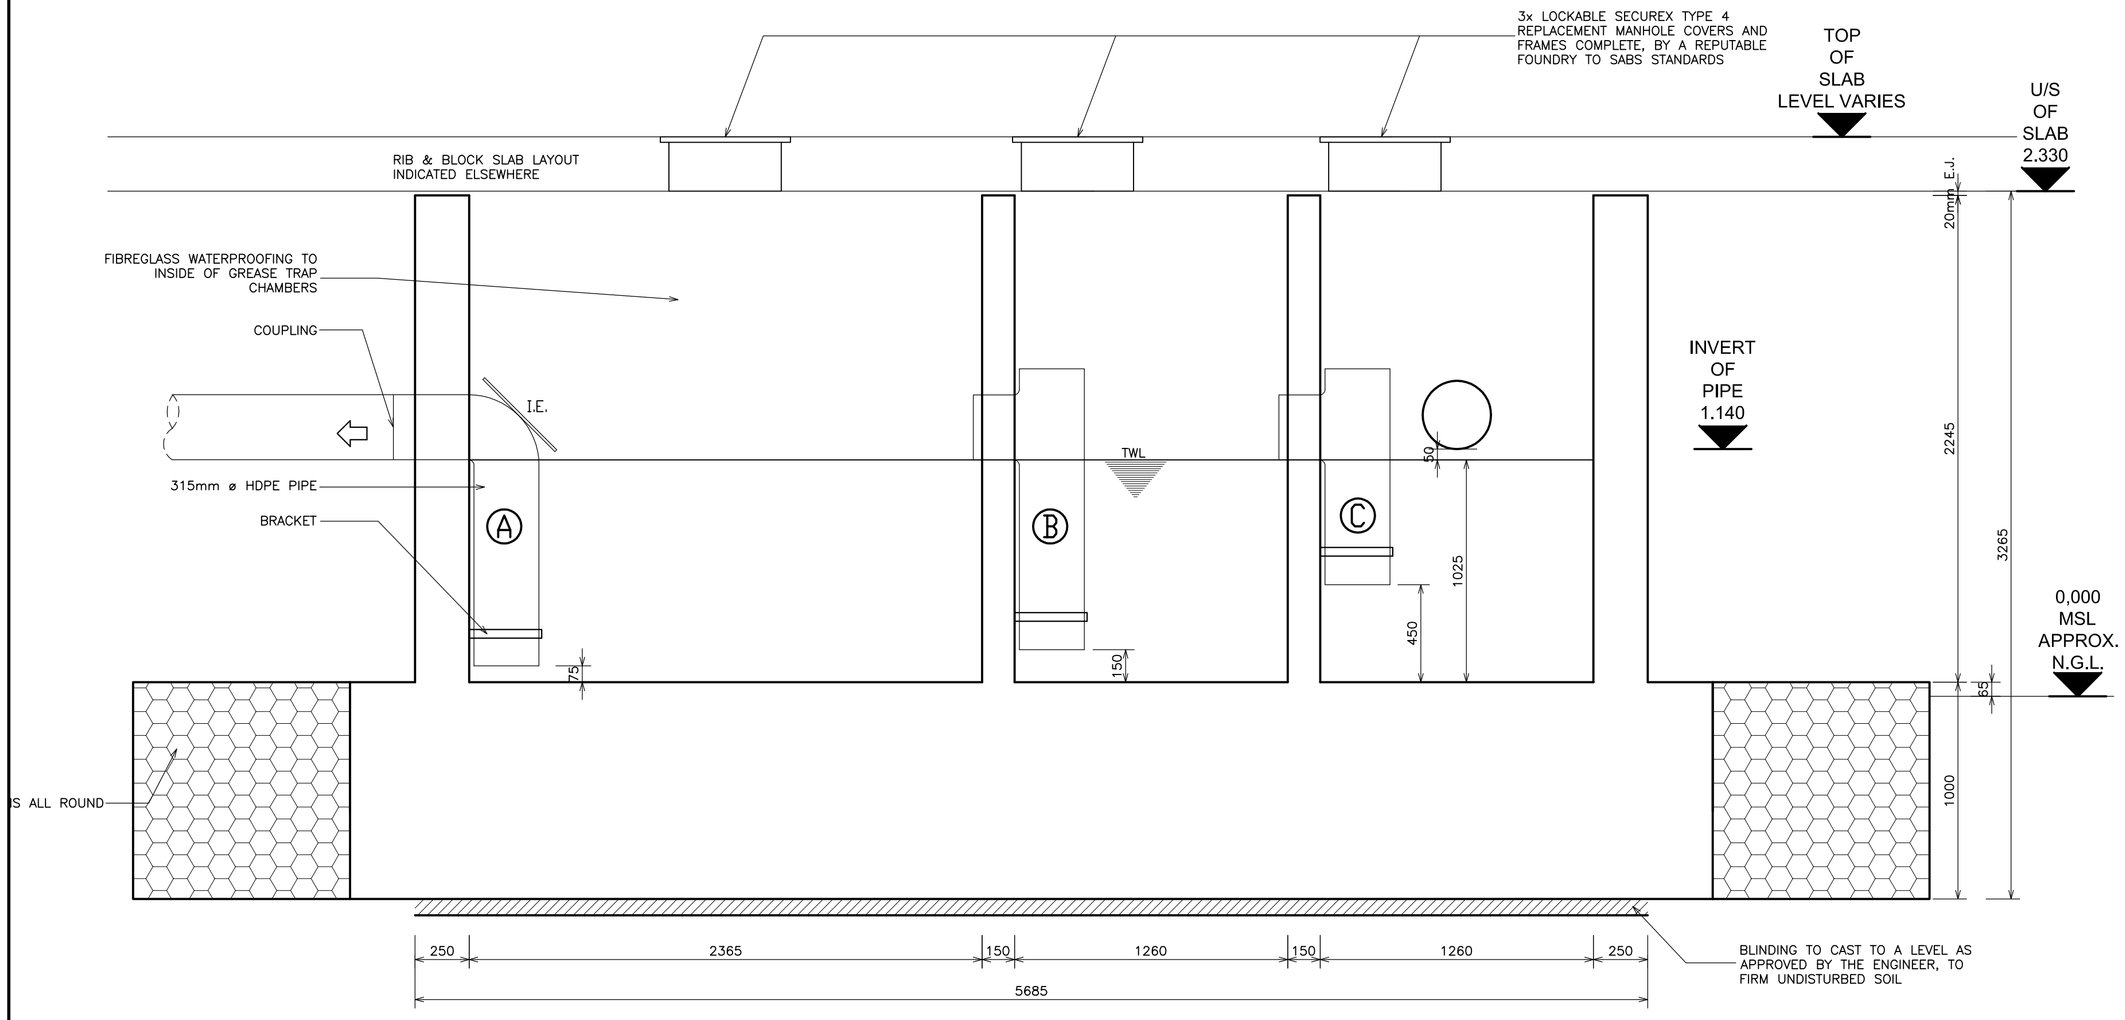


SECTION A
SCALE 1:20


AS BUILT FOUNDATION SIZE HAS BEEN INDICATED APPROXIMATELY ONLY

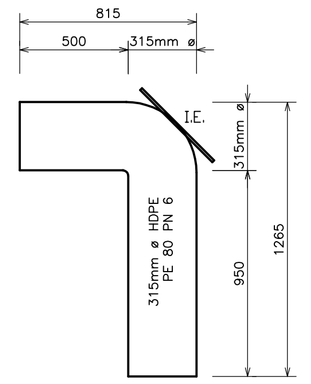


FITTING TYPE Ⓐ
SCALE 1:20
(1 THUS)

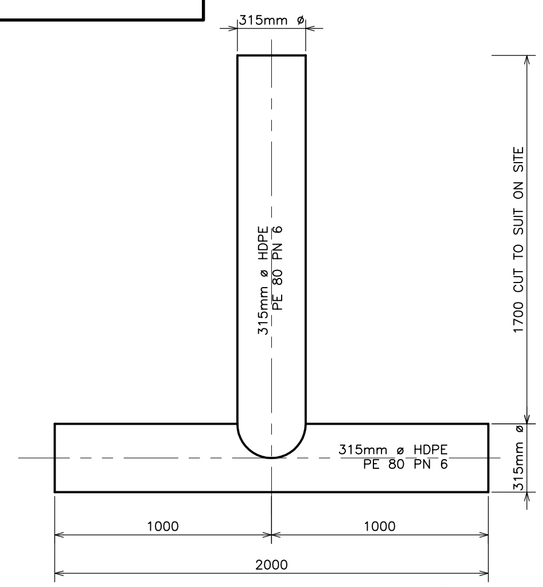


PLAN: FITTING TYPE Ⓓ
SCALE 1:20
(1 THUS)

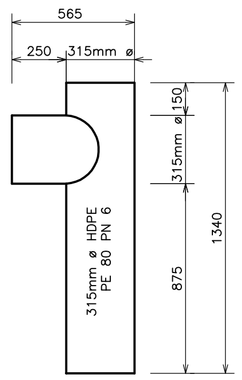


FITTING TYPE Ⓑ
SCALE 1:20
(1 THUS)

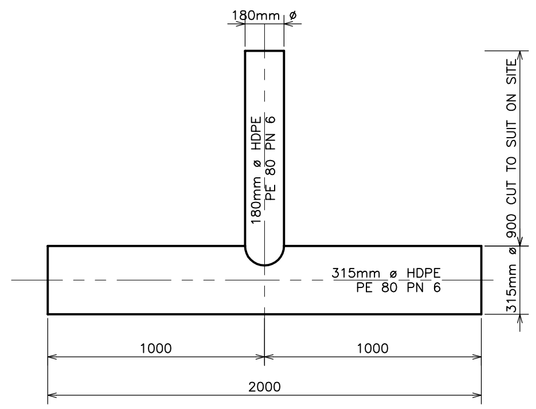

SIDE ELEVATION: FITTING TYPE Ⓔ
SCALE 1:20
(14 THUS)

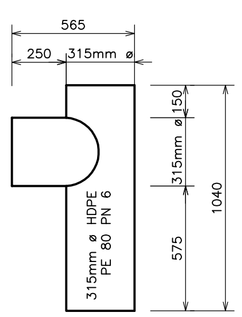

FITTING TYPE Ⓒ
SCALE 1:20
(1 THUS)

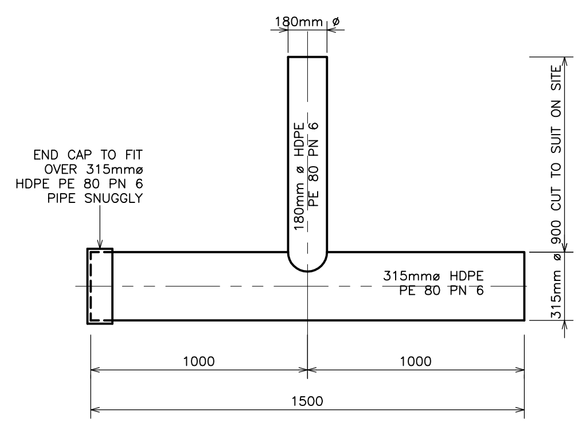

SIDE ELEVATION: FITTING TYPE Ⓕ
SCALE 1:20
(2 THUS)

AS BUILT DRAWING

IVO HUISMAN AND ASSOC. cc
CONSULTING STRUCTURAL AND CIVIL ENGINEERS
120 Cape Rd, Mill Park, Port Elizabeth, 6001
Tel: 041 373–5121/2, Fax: 041 373–5119
CK 88/13685/23

Rev.	Date	Description	By
01	09/03/2009	AS BUILT DRAWING	K.V.

Project title: **NPA - PORT ELIZABETH HARBOUR REHABILITATION OF DOM PEDRO QUAY**

Drawing title: **CONCRETE DECK PROPOSAL: PROPOSED OIL SEPARATOR**

Designed by I.L.H.	Pr Eng 840375	Scale 1:20
Drawn by S.J.B. & K.V.	ACAD	
Checked by	Pr Eng 840375	Date 25 OCTOBER 2007
Sheet size A1	DRAWING NO.	Contract 1233 / Drawing 15 / Rev 01

AS BUILT DRAWING